## 25ITB001 Fremont Dental Clinic Addendum #2 Q&A Follow-Up

Issued: 03/03/2025

1 of 1

Question Number	Date Received	Question	Answer
Q1-11	02/26/2025 10:47 AM	Addendum 1 response to Q1-6 provided contact information for JR at Henry Schein. In conversation with JR he advsied that SNHD, as a public services agency, gets preferred pricing that is not available to the GC's bidding this work. Henry Schein's team does do furnish and install of the DCI equipment. As such it would make sense that Key Note 2 on A200 be revised to state that the Base bid would be for the casework to be DCI as OFOI and selected GC will coordinate with Specialist team for the backing and utility connections. The Alternate/Bid option pricing would be for GC to proivde pricing option for the casework, counters and install. This would allow the option to be determined at time of award, based on SNHD's quote from Henry Schein. Please proivde direction on how to we are to bid on this option. (RFI-11)	
Q1-12	02/26/2025 10:47 AM	Addendum #1 did not provide the sign in sheets from the site walk. Please provide copy of sign in sheets. (RFI-2)	Inluded here.
Q2-1	03/03/2025 8:52 AM	Can you please tell me what the deck height is on this building?	The roof deck height varies. Per as-built drawings, the parapet height at this area is 23'-6". See as-built drawing included here.

## 25ITB001 Fremont Dental Clinic Mandatory Site Visit Attendee List 02/10/2025, 2:00 PM PST

#	Şignature	Name	Title	Company	Email
	filt freeze	Rick Prado	Compliance Officer	Southern Nevada LLMC	<u>Rick@snvlmcc.org</u>
	X	Chi Chi Bengochea	Owner	Bentar Development	chichib@bentar.com
1	Blacil	Guy Casciola	New Business Development	ABS Facility Services	guy@4abs.net
2	Uni	Abe Ensour	Sales Manager	AV Lux Tech	abe@avluxtech.com
3	201	Daniel Frehner	Estimator	Baldwin Demolition	<u>daniel@baldwinlv.com</u>
4	Cost on Colonex	Curt McClincy	President	CM Builders	curt@cmbuilderslv.com
4	Pagualotto	Paul Pasqualotto	Superintendent	CM Builders	pspshow24@gmail.com
5	X	Edward Frasier	Business Development	Cobblestone Construction	efrasier@cobblestoneconstruction.org
5	X	Joseph Montijo	Estimator	Cobblestone Construction	imontijo@cobblestoneconstruction.org
6	X	Pat Holland	HVAC Manager	Cold-Tech Refrigeration	pholland@cold-tech.com
7	CA	AJ Hamilton	AJ Hamilton	Eagle One Construction	austin@eoc-gc.com
7	×	Brian Guckin	Research Dvlpment. Tech.	Eagle One Construction	brian@eoc-gc.com

## 25ITB001 Fremont Dental Clinic Mandatory Site Visit Attendee List 02/10/2025, 2:00 PM PST

#	Signature	Name	Title	Company	Email
8	X	Romelle Emmanuel	Owner	Emmanuel Environmental	romelle@emmanuelenvironmental.com
9	A MARINA	Danny Arango Zacarias	Jr. Estimator	Kalb Industries of NV	danny@kalbind.com
9	711	Nick Gaston	Estimator	Kalb Industries of NV	Nick@kalbind.com
10	Jason a. Burnette	Jason Burnette	Project Executive	The Korte Co	jason.burnette@korteco.com
10	Jo sul	Joe Barber	Project Estimator	The Korte Co	joe.barber@korteco.com
11	X	Carlos Avila	VP/Sr. Estimtor	Live Electric	carlos@liveelectric.vegas
12	10s	Keith VandeBrake	Sr. Project Manager	Martin Harris Construction	keith.vandebrake@martinharris.com
12	505	Steve O'Sullivan	Senior Estimator	Martin Harris Construction	Nick@kalbind.com
13	X	David Berkowitz	Sr. Project Manager	Move 4 Less Moving	david@move4lessmoving.com
14	Meyly	Shawn Shahryari	President	Platinum Construction Group	shawn.shahryari@gmail.com
15	Carr	Carlos Juarez	Project Manager/ Estimator	Plumb Crazy Solutions	carlos.plumbcrazy1@gmail.com
16	Bur	Kerry Willey	Estimator	Rafael Framers	Kerry.Willey@RafaelCompanies.com


## 25ITB001 Fremont Dental Clinic Mandatory Site Visit Attendee List 02/10/2025, 2:00 PM PST

#	Signature	Name	Title	Company	Email
17	1	Mark Ridley	Manager	R&M Construction	mridley@rmconstructionservicellc.com
	Me Rily JankGongez				
18	7	Juan Gomez	Project Manager/	ROD Specialities	juan.specialties@gmail.com
	Jan Gonge		Estimator		
19		Manny Woods	Project Manager	Sin City RE Heating	mwoods.sincitylv@gmail.com
				& Cooling	
19		Jasmine Acevedo	Admin/Estimator	Sin City RE Heating	jasmine.sincitylv@gmail.com
				& Cooling	
20	1 Alm	Jeff Nichol	Project Manager/	Yack Construction	jeffn@yackconstruction.net
	NII Iwh		Estimator		
	Want Kanlin	PAUL	ESTIMATOR	nte Konte Co.	ON FILE
10	10 cm van con	KAMBERIS			7,126

25ITB001 Fremont Dental Clinic Mandatory Site Visit Attendee List (NO FORM) 02/10/2025, 2:00 PM PST

#	Signature	Name	Title	Company	Email
21	7.26	Touth Grandlin	Estimutar/PM	MONUMENT	ON PILE
21	M	Rochelle Dzisam	Bids coodenter	Monumen+	bids & buldmonuments.com
22	Moderales	Paniel Salcelo	Estimating	SHE INTERNATIONAL	- d on Pile
ひり	Drover Shellhit	Tracic Shellhart	Estimating	SCOPE LOWINGEN	Clo SI+MUN@ SCOPELONTANTING. Gom
24	Thomas Moore	1~		63 EXECTAGE	TMOORED 63 ELECTRIEN. com
25	ALAH BIDDLE	Mithield	Construct Ul organ	KOR BUILDING GROUP	ALAN OKORBE. Com
26	Hank Hatter	Les		S31+ INC.	It ANK. ITAFFY & S3IT INC. com
			~		


3 COAT STUCCO SYSTEM WITH SYNTHETIC OR COMP. WOOD FINISH - SEE ELEV.

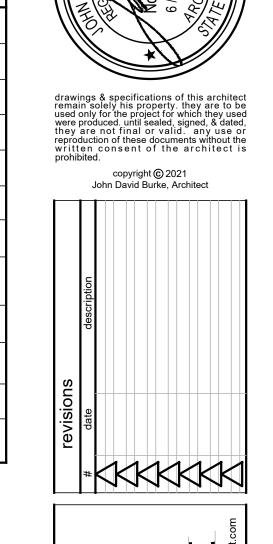


**REVIEWED FOR** 

Aug 20 2021

Rob S

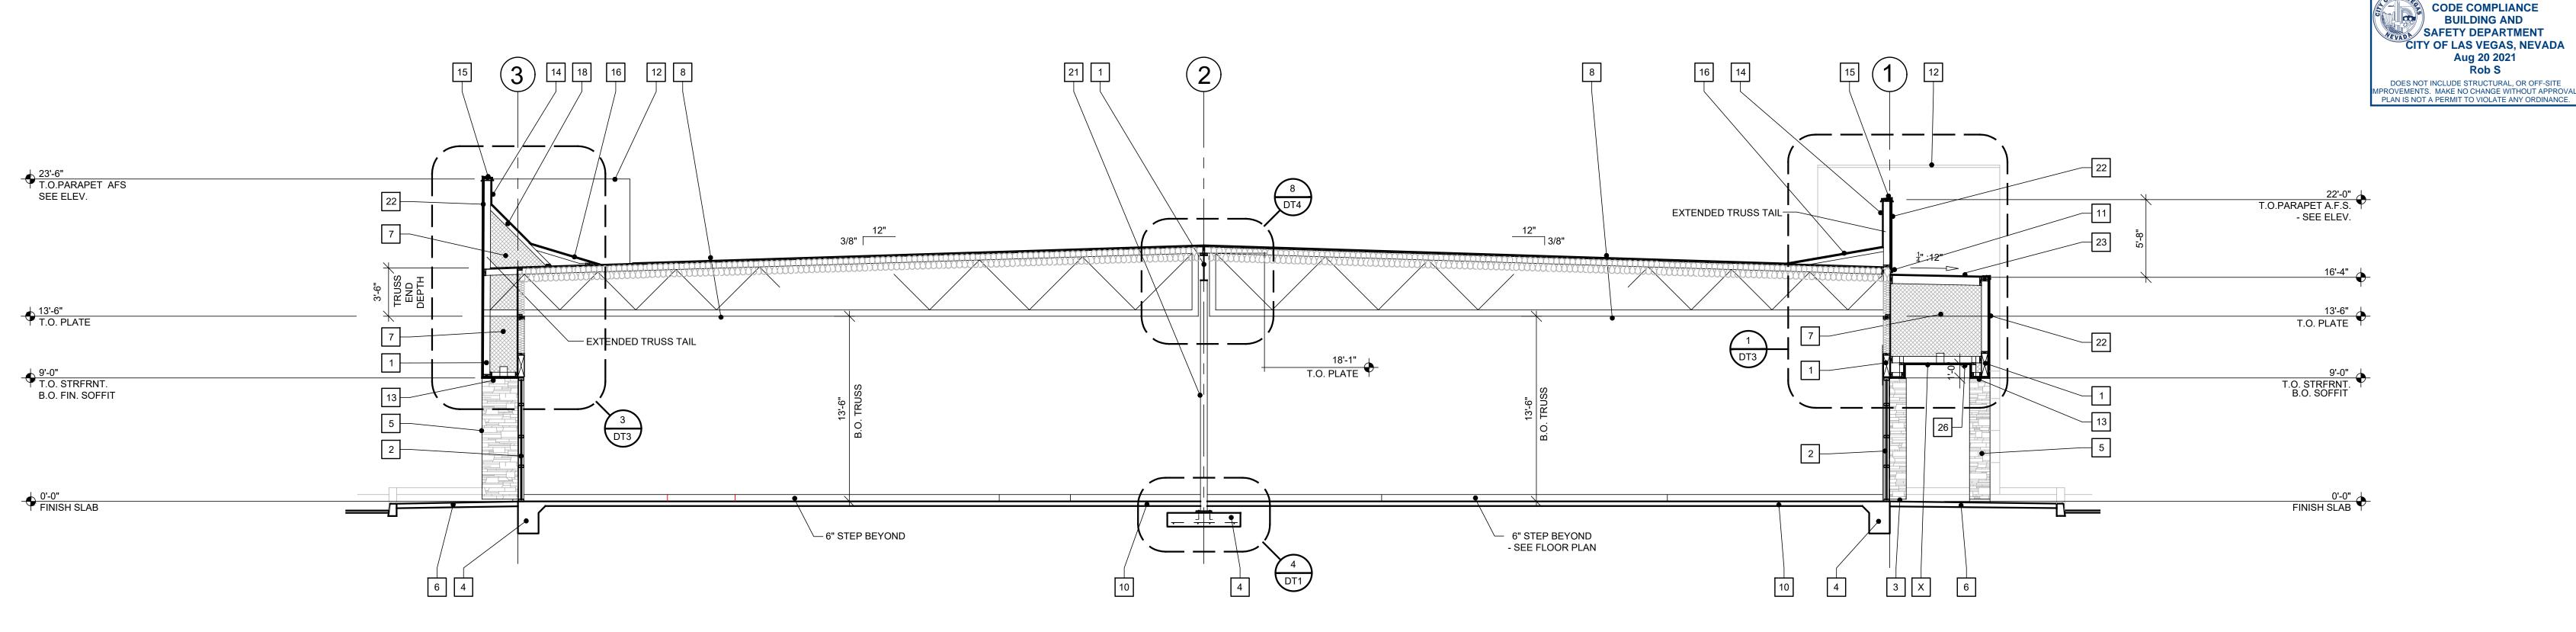

**Building Section 4** 

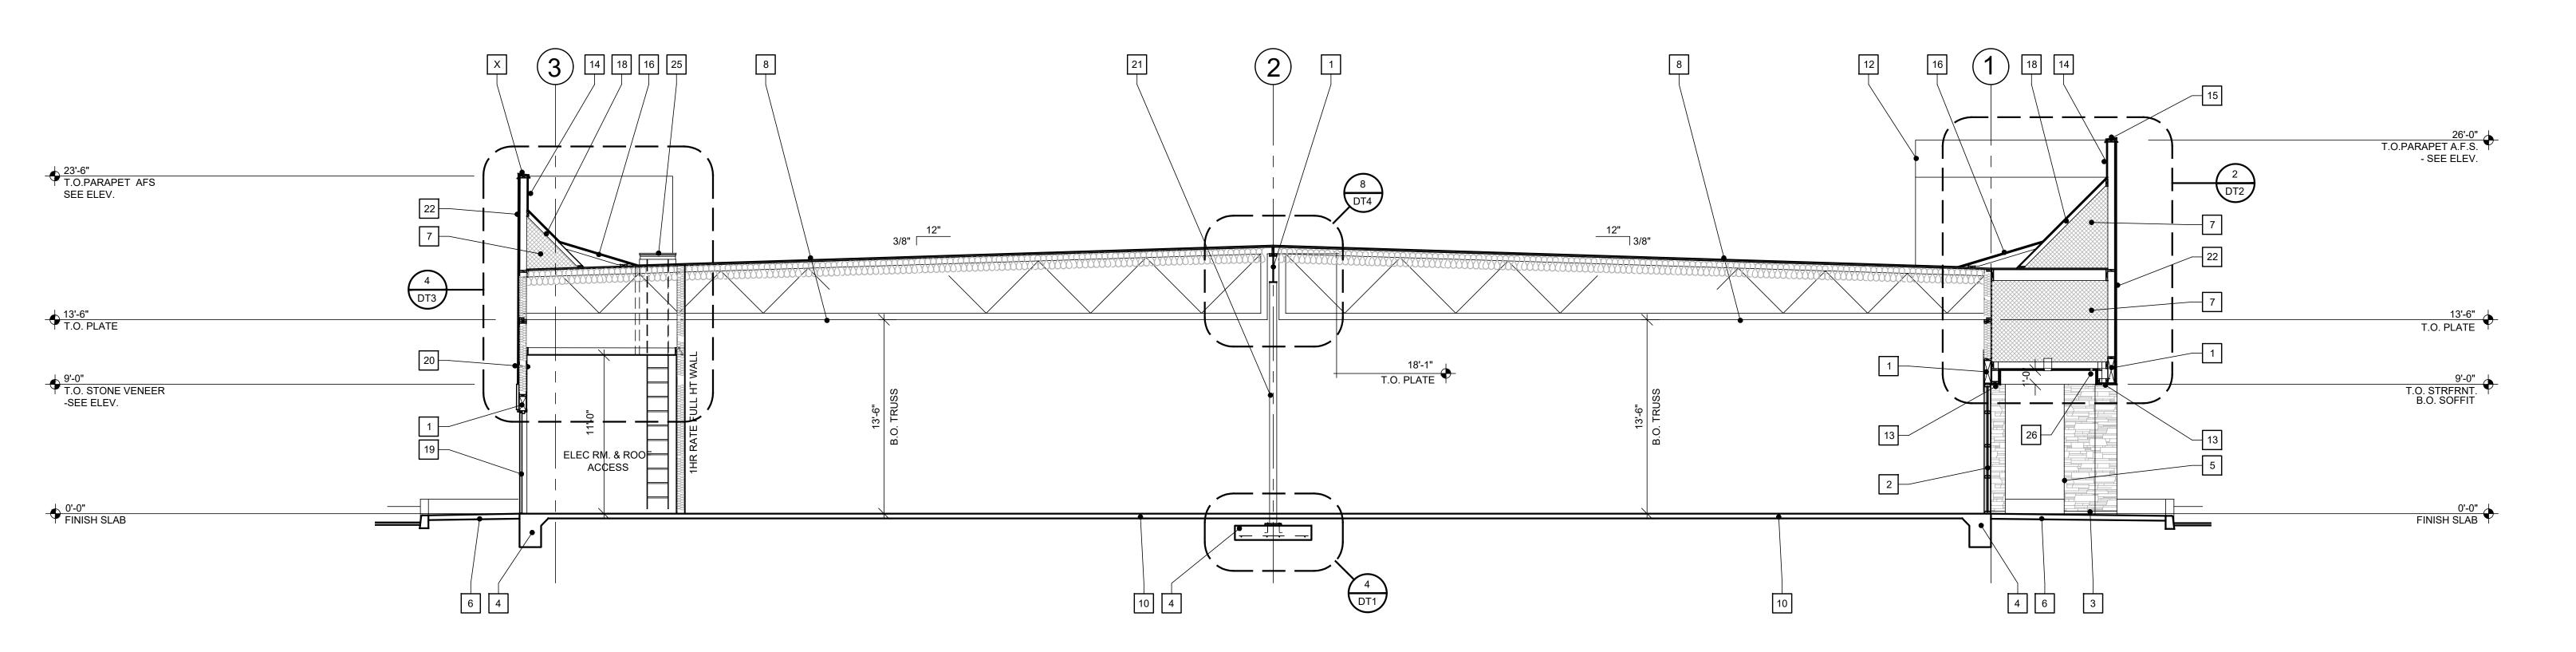

**Building Section 3** 

Office Building
Showboat Project
r. Bentar Development
Las Vegas

Building Sections

Scale: 3/16" = 1'-0"